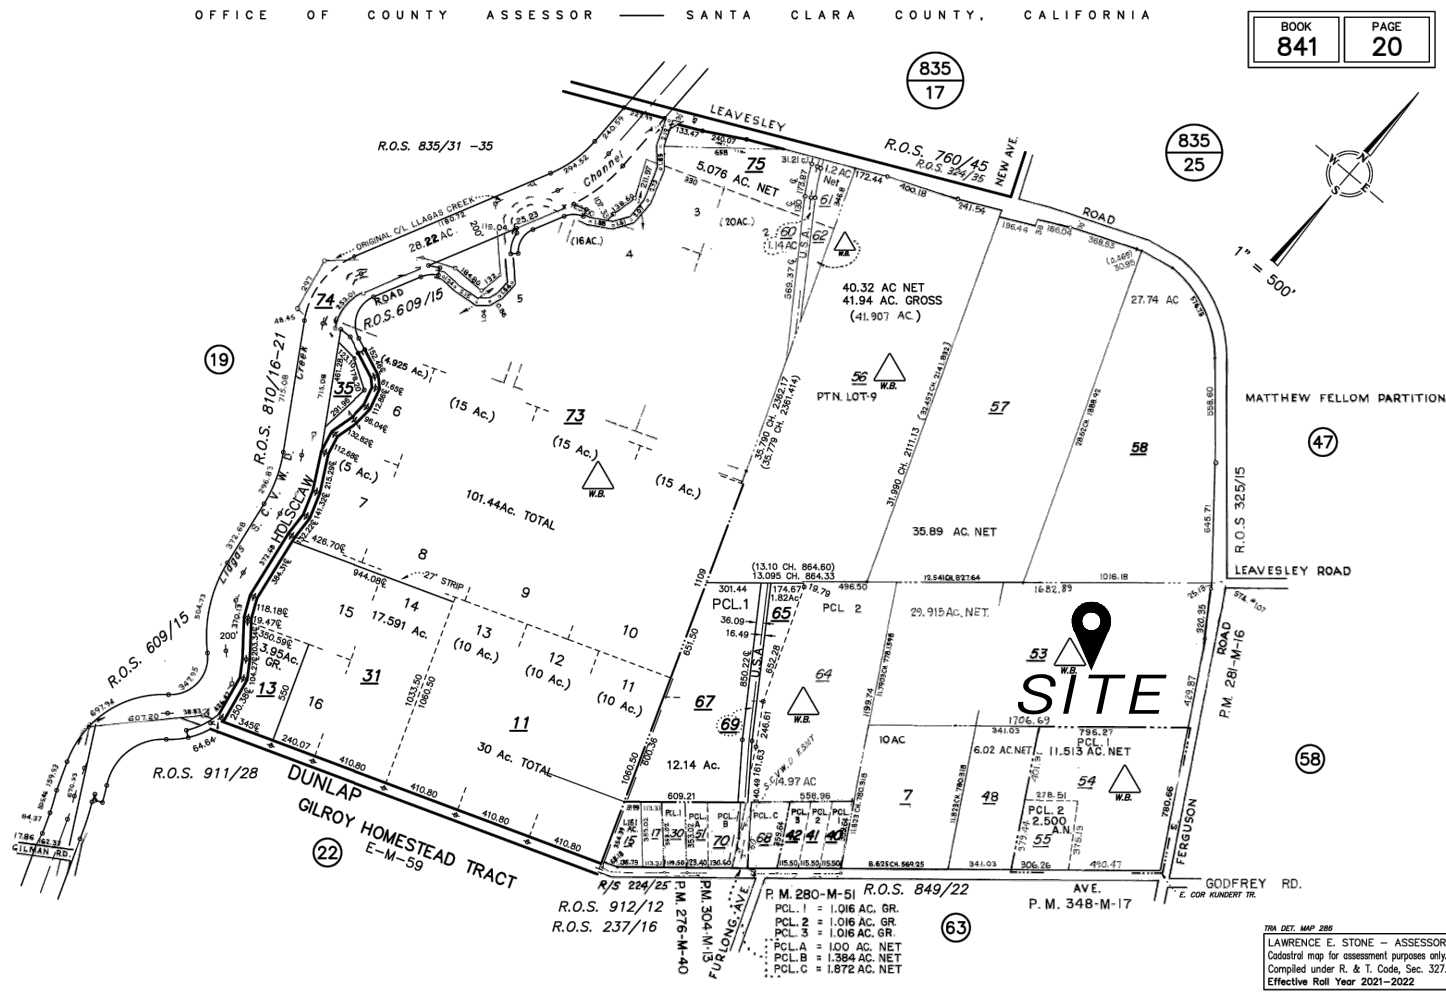


GILROY RODEO
7955 FERGUSON ROAD
GILROY, CA 95020
EXISTING STRUCTURES
BUILDING-F: MILK BARN

PARCEL MAP	CODE REQUIREMENTS	PROJECT DATA	DRAWING INDEX	
	2019 CALIFORNIA BUILDING CODE 2019 CALIFORNIA MECHANICAL CODE 2019 CALIFORNIA PLUMBING CODE 2019 CALIFORNIA ELECTRICAL CODE 2019 CALIFORNIA ENERGY CODE 2019 CALIFORNIA FIRE CODE 2019 CALIFORNIA GREEN BUILDING STANDARDS CODE SANTA CLARA COUNTY ZONING ORDINANCE SANTA CLARA COUNTY APPLICABLE CODES	APN: 841-20-053 ZONING DISTRICT: A-40Ac PARCEL SIZE: 29.91 Acres (1,302,879.67 SF) OCCUPANCY GROUP: U (MILK BARN) CONSTRUCTION TYPE: VB NO. OF FLOORS: 1 (ONE) 1ST FLOOR: 2,933 SF TOTAL AREA: 2,933 SF	ARCHITECTURAL A0.00 COVER SHEET A0.01 EXISTING SITE PLAN A1.00 EXISTING FLOOR PLAN A1.01 EXISTING ELEVATIONS A1.02 EXISTING SECTIONS A1.03 EXISTING REFLECTED CEILING PLAN	
PROJECT DIRECTORY	DEFERRED SUBMITTAL / PERMITS	SCOPE OF WORK		
		RECORD AR21-1957 EXISTING AS BUILT DRAWINGS FOR AG EXEMPTION		
SPECIAL INSPECTION REQUIREMENT	ALLOWABLE AREA CALCULATION			
SPRINKLER REQUIREMENT: NO				

REID LERNER ARCHITECTS

PHONE 408-842-9942

FAX 408-842-9971

REIDLERNER@YAHOO.COM

7680 MONTEREY ST #105

GILROY, CA 95020

REID LERNER ARCHITECTS

PHONE 408-842-9942

FAX 408-842-9971

REIDLERNER@YAHOO.COM

7680 MONTEREY ST #105

GILROY, CA 95020

REID LERNER ARCHITECTS

PHONE 408-842-9942

FAX 408-842-9971

REIDLERNER@YAHOO.COM

7680 MONTEREY ST #105

GILROY, CA 95020

FURTADO RANCH

7955 FERGUSON ROAD

GILROY, CA 95020

EXISTING STRUCTURES BUILDING: F

MILK BARN

COVER SHEET

Drawn

VE

Checked

RL

Date

05.06.22

Scale


AS NOTED

Issued For


DRAFT

Sheet

A0.00

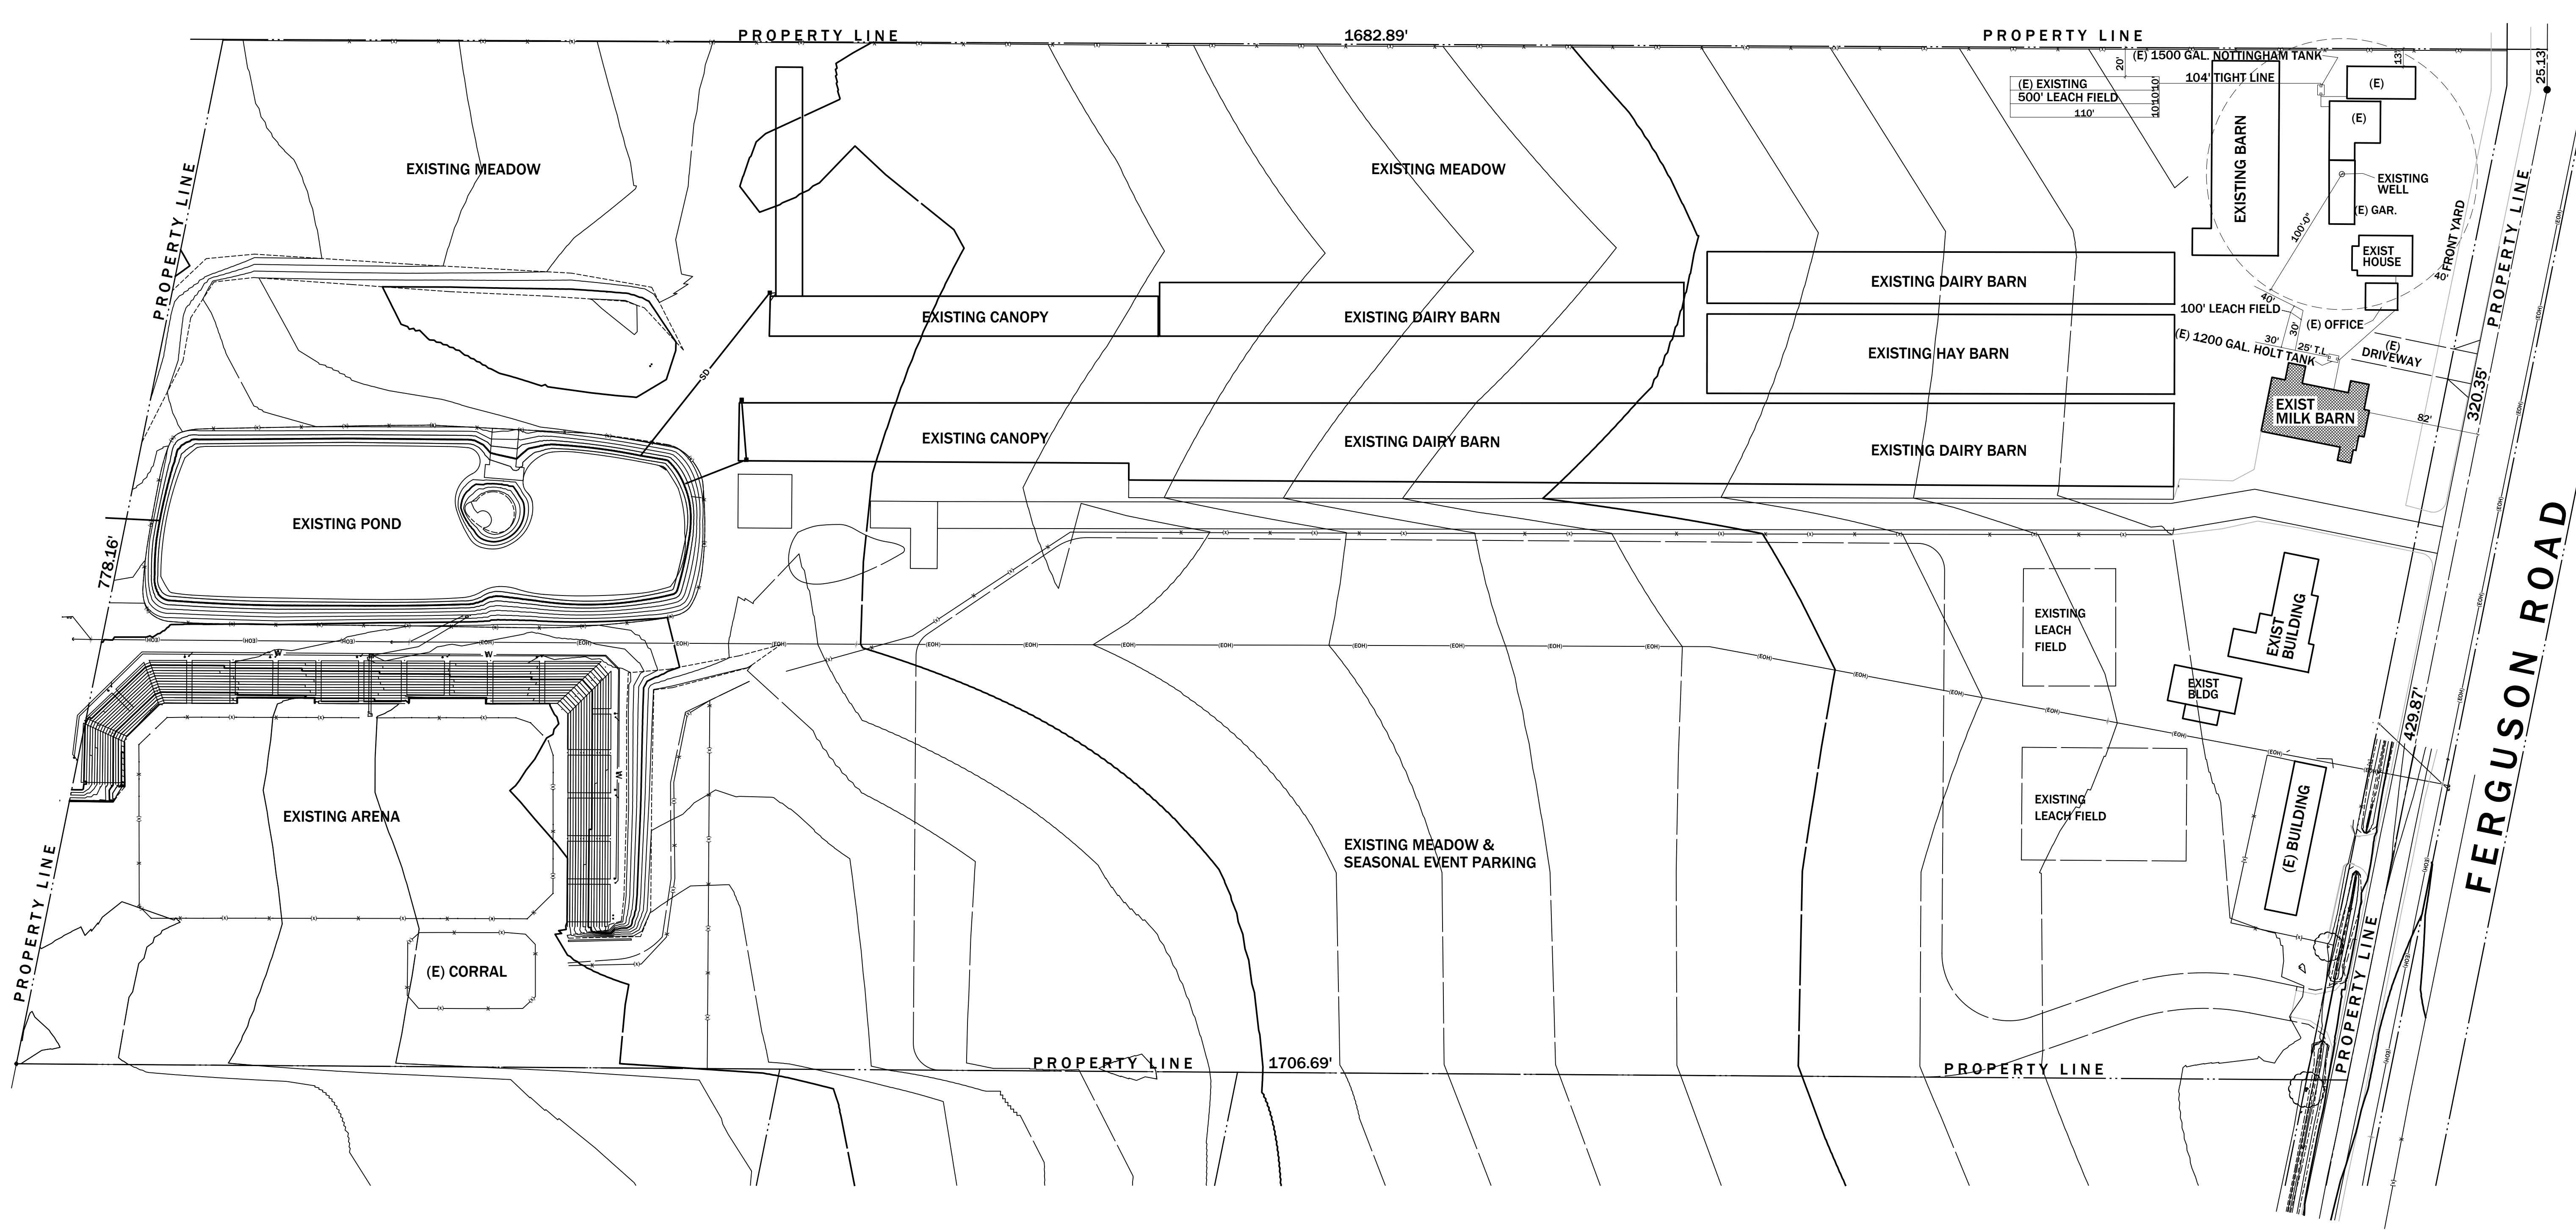

SITE PLAN

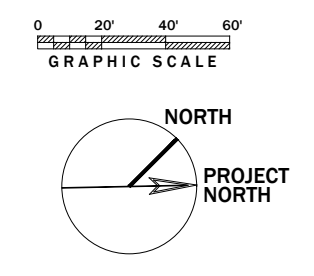

NO.	REVISION	DATE	BY
1			
2			
3			
4			




REID LERNER ARCHITECTS
PHONE 408-842-9942
FAX 408-842-9971
REIDLERNER@YAHOO.COM
7680 MONTEREY ST #105
GILROY, CA 95020

FURTADO RANCH
7955 FERGUSON ROAD
GILROY, CA 95020
EXISTING STRUCTURES BUILDING: F

MILK BARN
EXISTING SITE

Drawn	VE
Checked	RL
Date	05.06.22
Scale	1" = 60'-0"
Issued For	PERMIT
Sheet	

A0.01

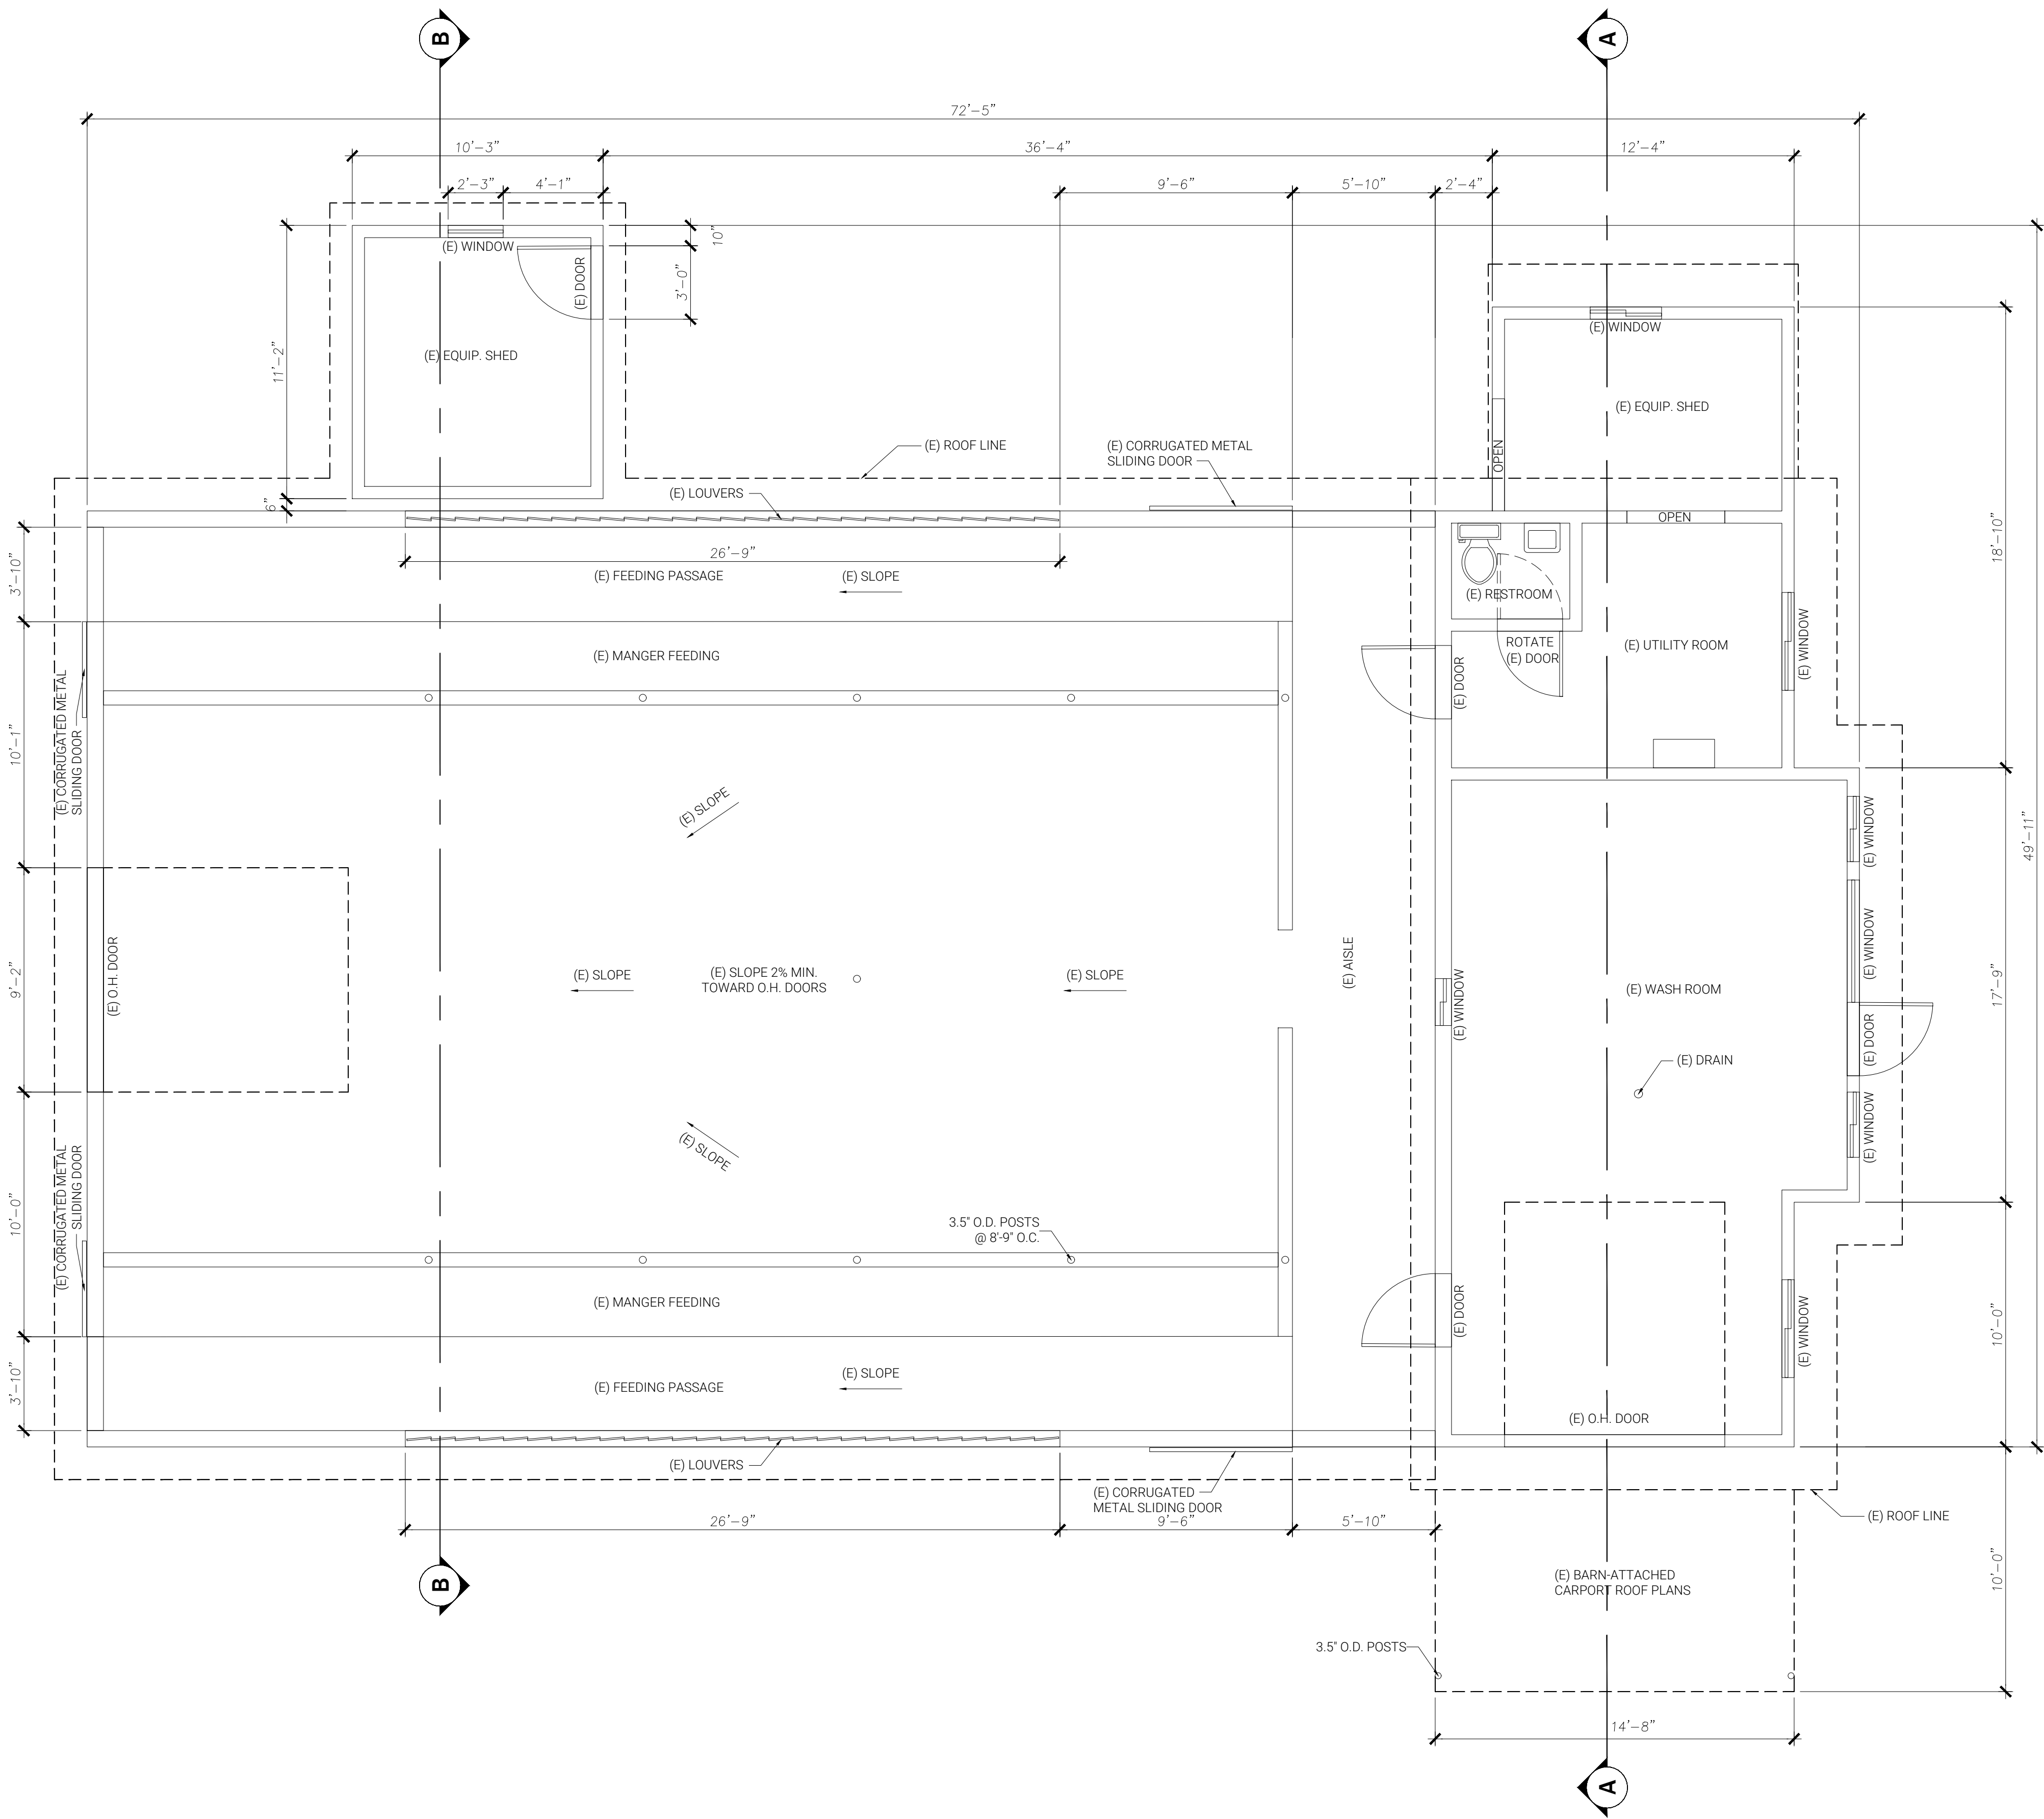

1 EXISTING FLOOR PLAN

SCALE: 1/4"=1'-0"

NO.	REVISION	DATE	BY
1			
2			
3			
4			




REID LERNER ARCHITECTS
PHONE 408-842-9942
FAX 408-842-9971
REIDLERNER@YAHOO.COM
7680 MONTEREY ST #105
GILROY, CA 95020

FURTADO RANCH
7955 FERGUSON ROAD
GILROY, CA 95020
EXISTING STRUCTURES BUILDING: F


MILK BARN EXISTING
FLOOR PLAN

Drawn VE
Checked RL
Date 05.06.22
Scale AS NOTED
Issued For PERMIT
Sheet


A1.00

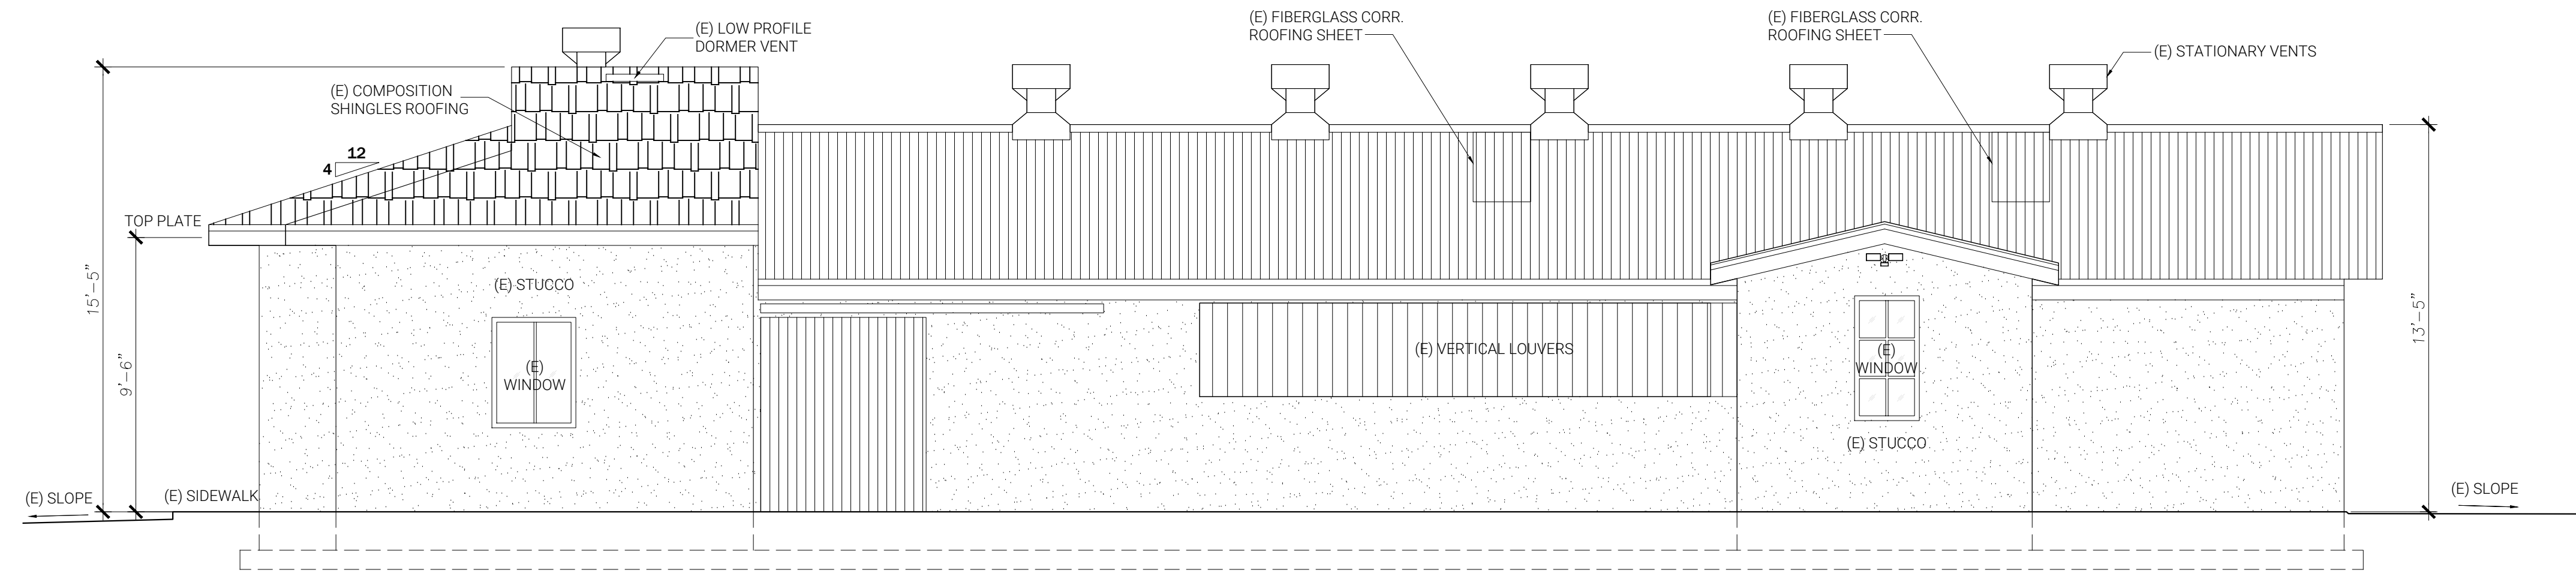


4 WEST ELEVATION
SCALE: 1/4"=1'-0"

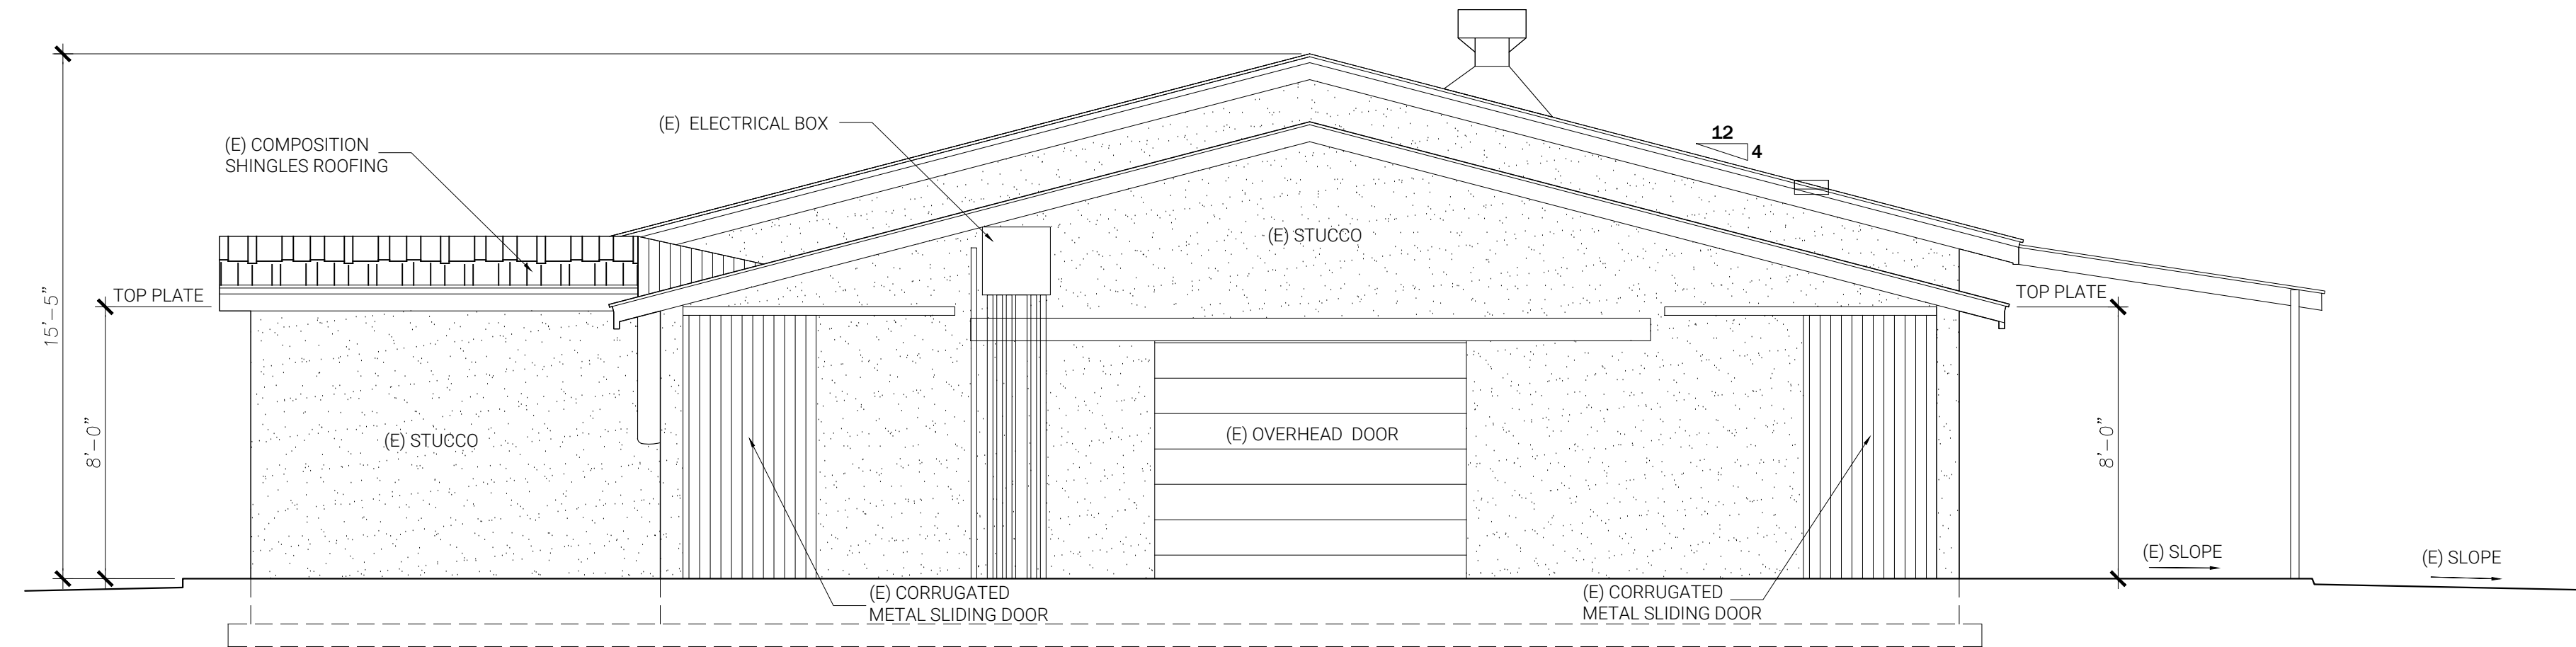

3 SOUTH ELEVATION
SCALE: 1/4"=1'-0"

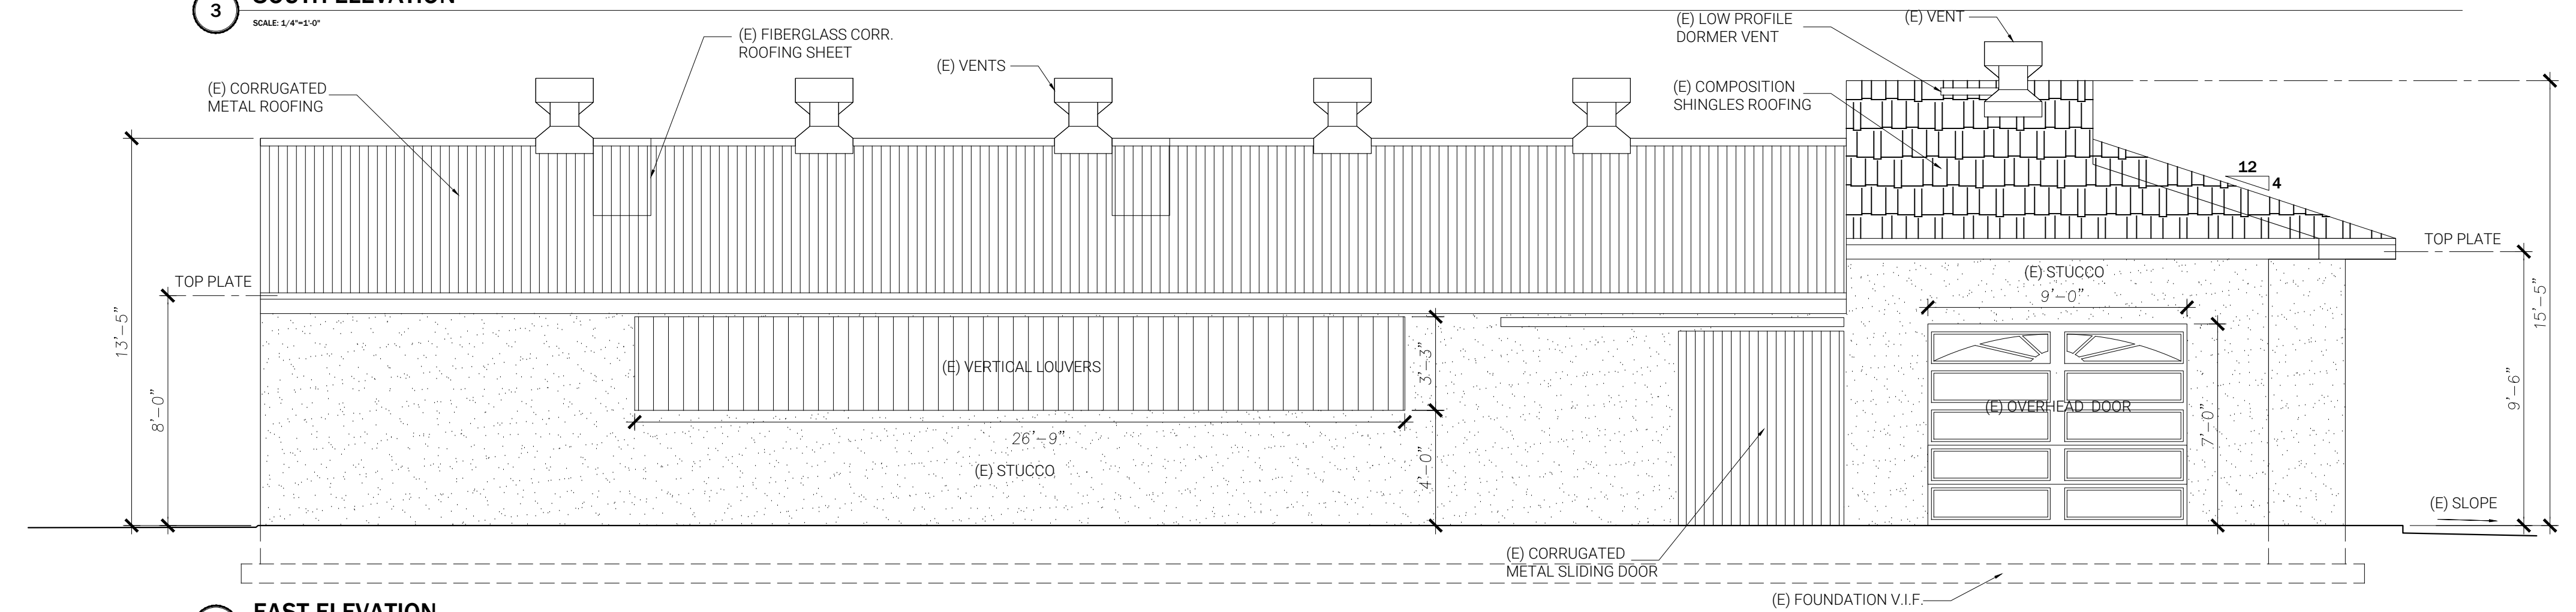


2 EAST ELEVATION
SCALE: 1/4"=1'-0"

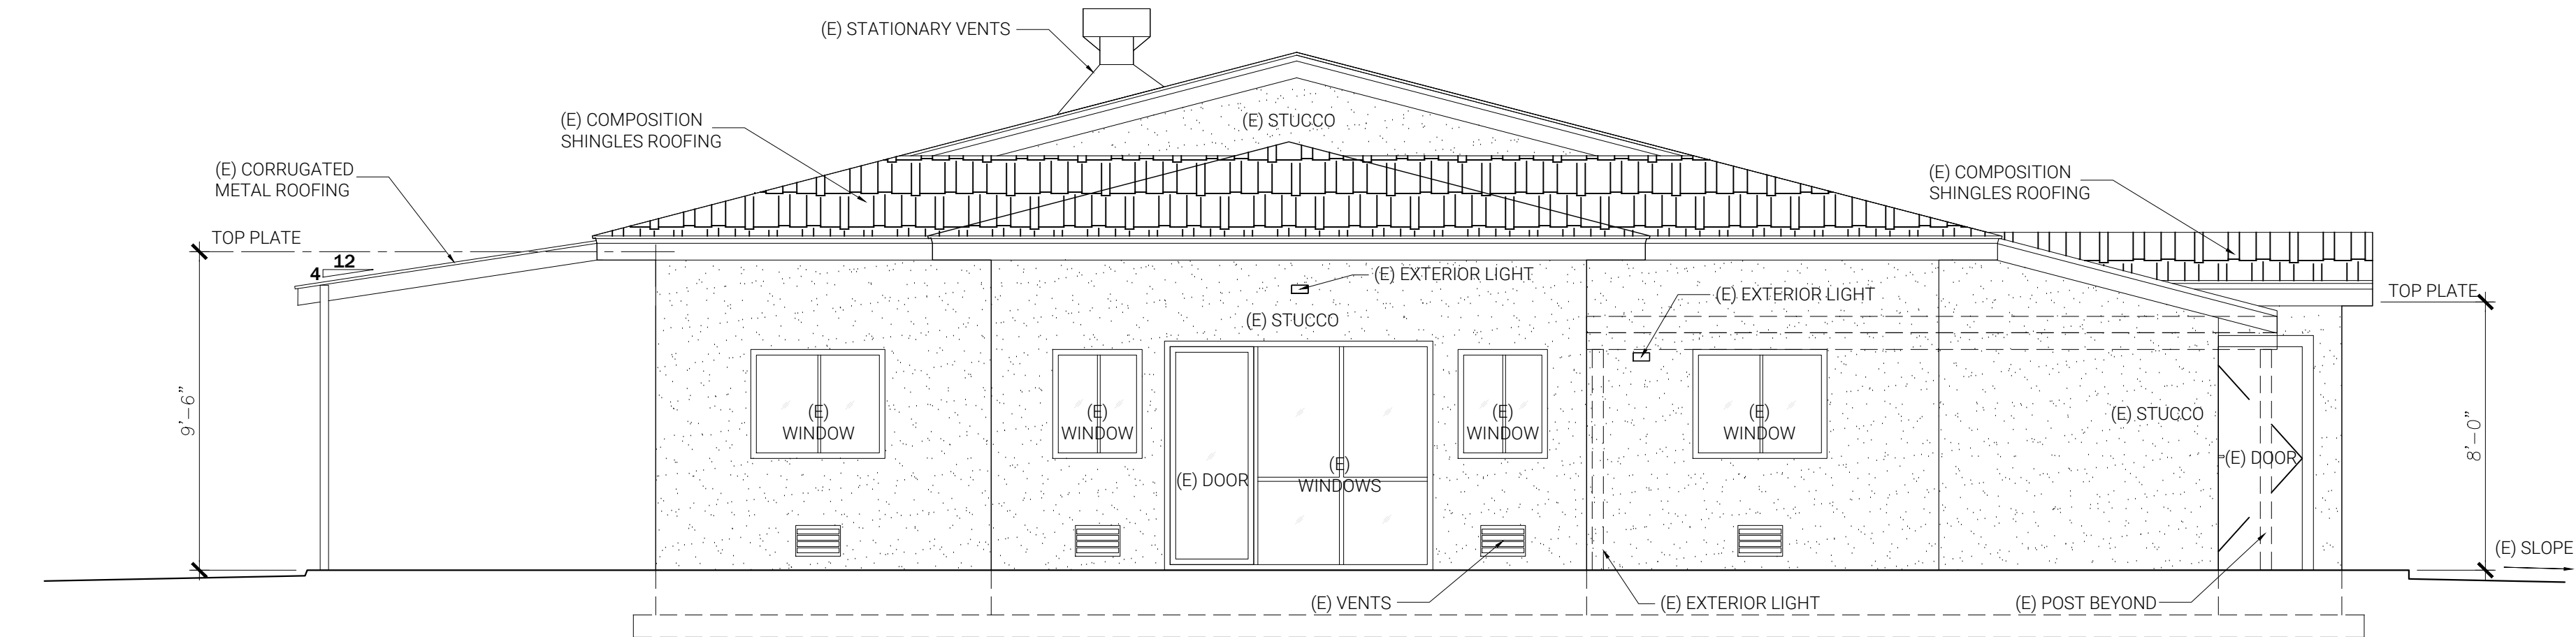

1 NORTH ELEVATION
SCALE: 1/4"=1'-0"

NO.	REVISION	DATE	BY
1			
2			
3			
4			

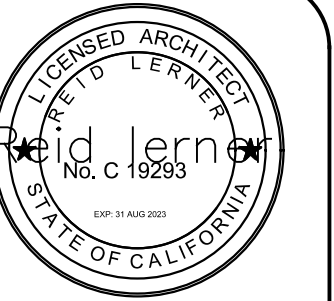

REID LERNER ARCHITECTS
PHONE 408-842-9942
FAX 408-842-9971
REIDLERNER@YAHOO.COM
7680 MONTEREY ST #105
GILROY, CA 95020

FURTADO RANCH
7955 FERGUSON ROAD
GILROY, CA 95020
EXISTING STRUCTURES BUILDING: F

MILKING BARN
(E) ELEVATIONS

Drawn VE
Checked RL
Date 05.06.22
Scale AS NOTED
Issued For PERMIT
Sheet

A1.01



REID LERNER ARCHITECTS
PHONE 408-842-9942
FAX 408-842-9971
REIDLERNER@YAHOO.COM
7680 MONTEREY ST #105
GILROY, CA 95020


FURTADO RANCH
7955 FERGUSON ROAD
GILROY, CA 95020
EXISTING STRIPCIURES BUDDING: E

MILKING BARN EXISTING SECTIONS

Drawn	VE
Checked	RL
Date	05.06.22
Scale	AS NOTED
Issued For	PERMIT
Sheet	

A1.02

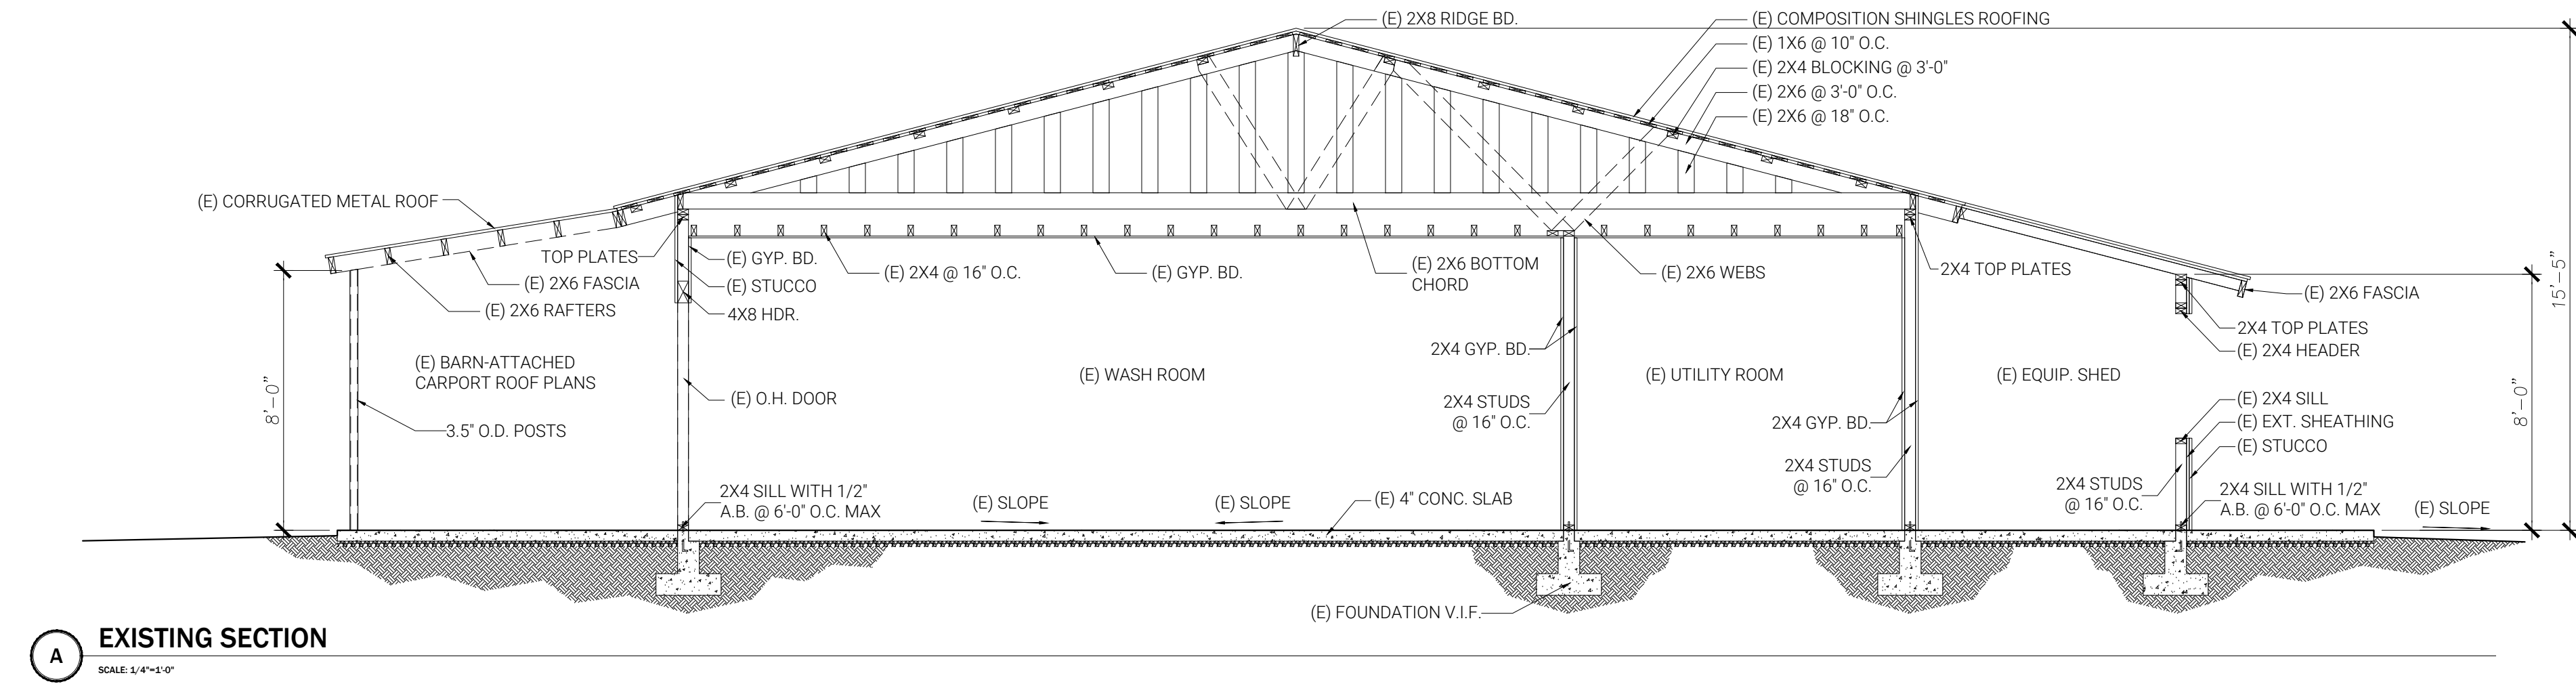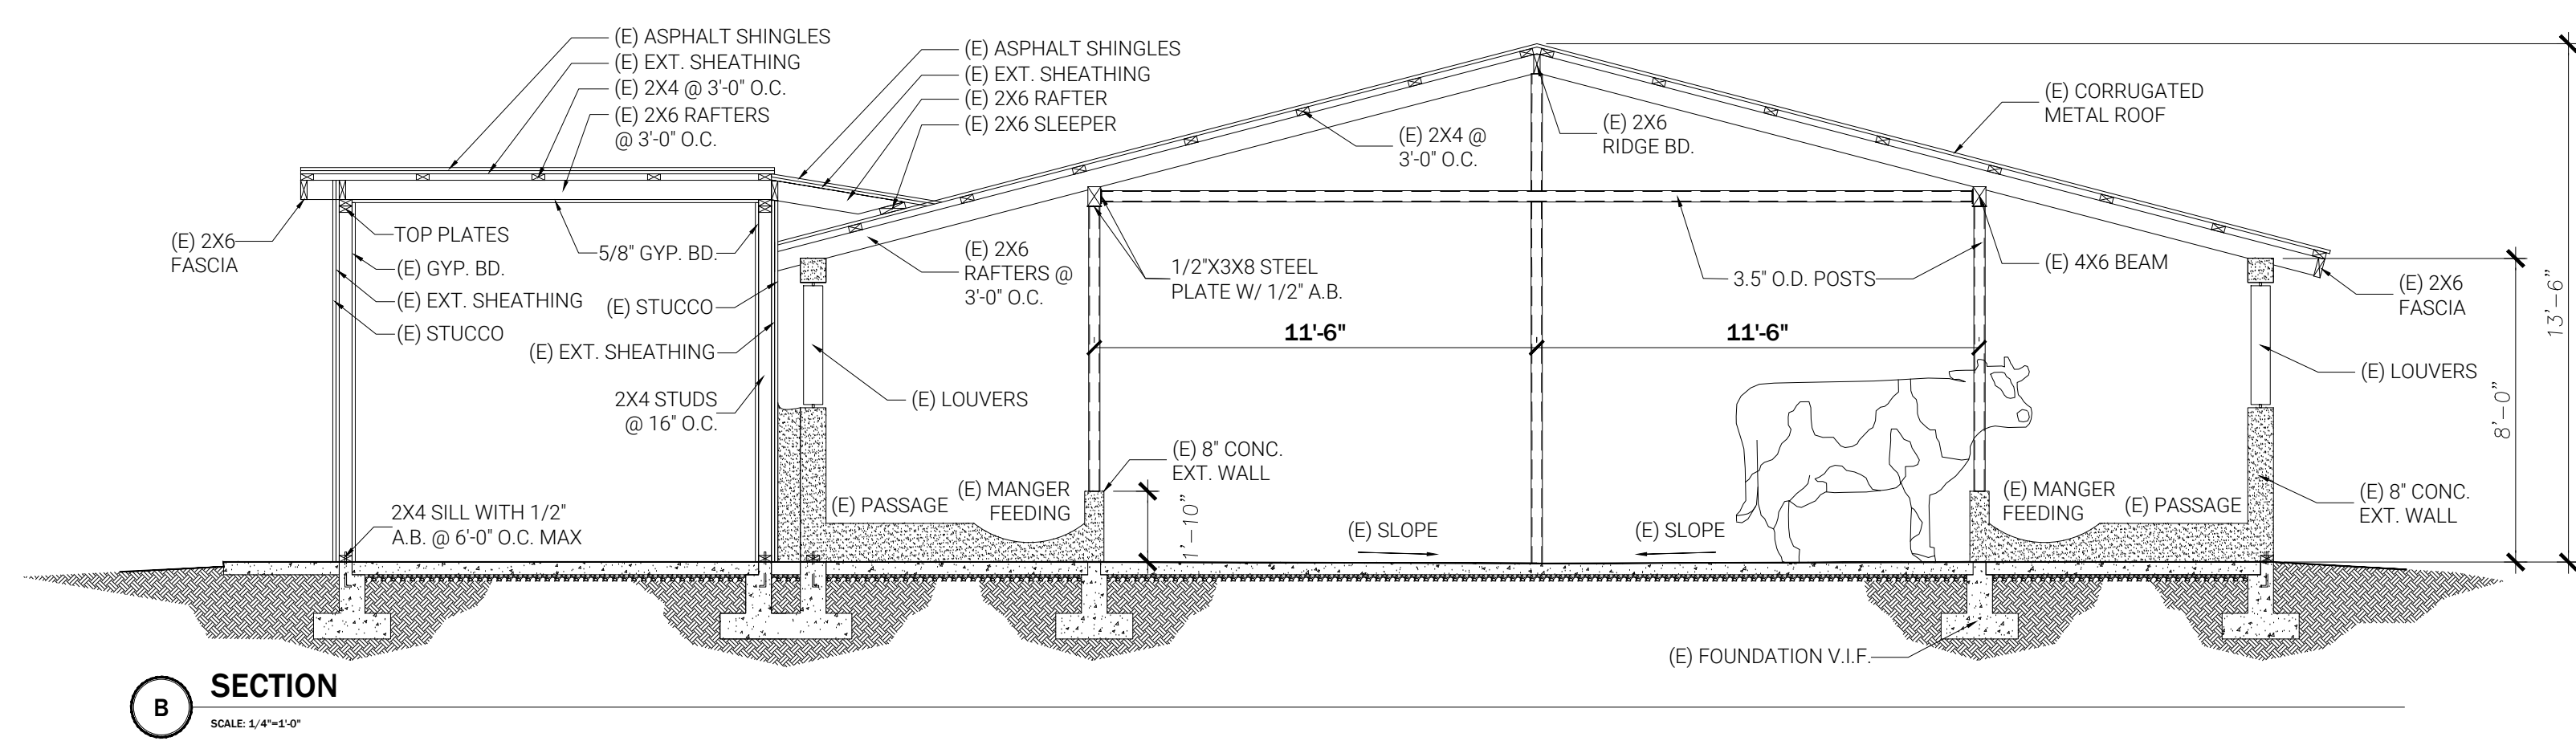

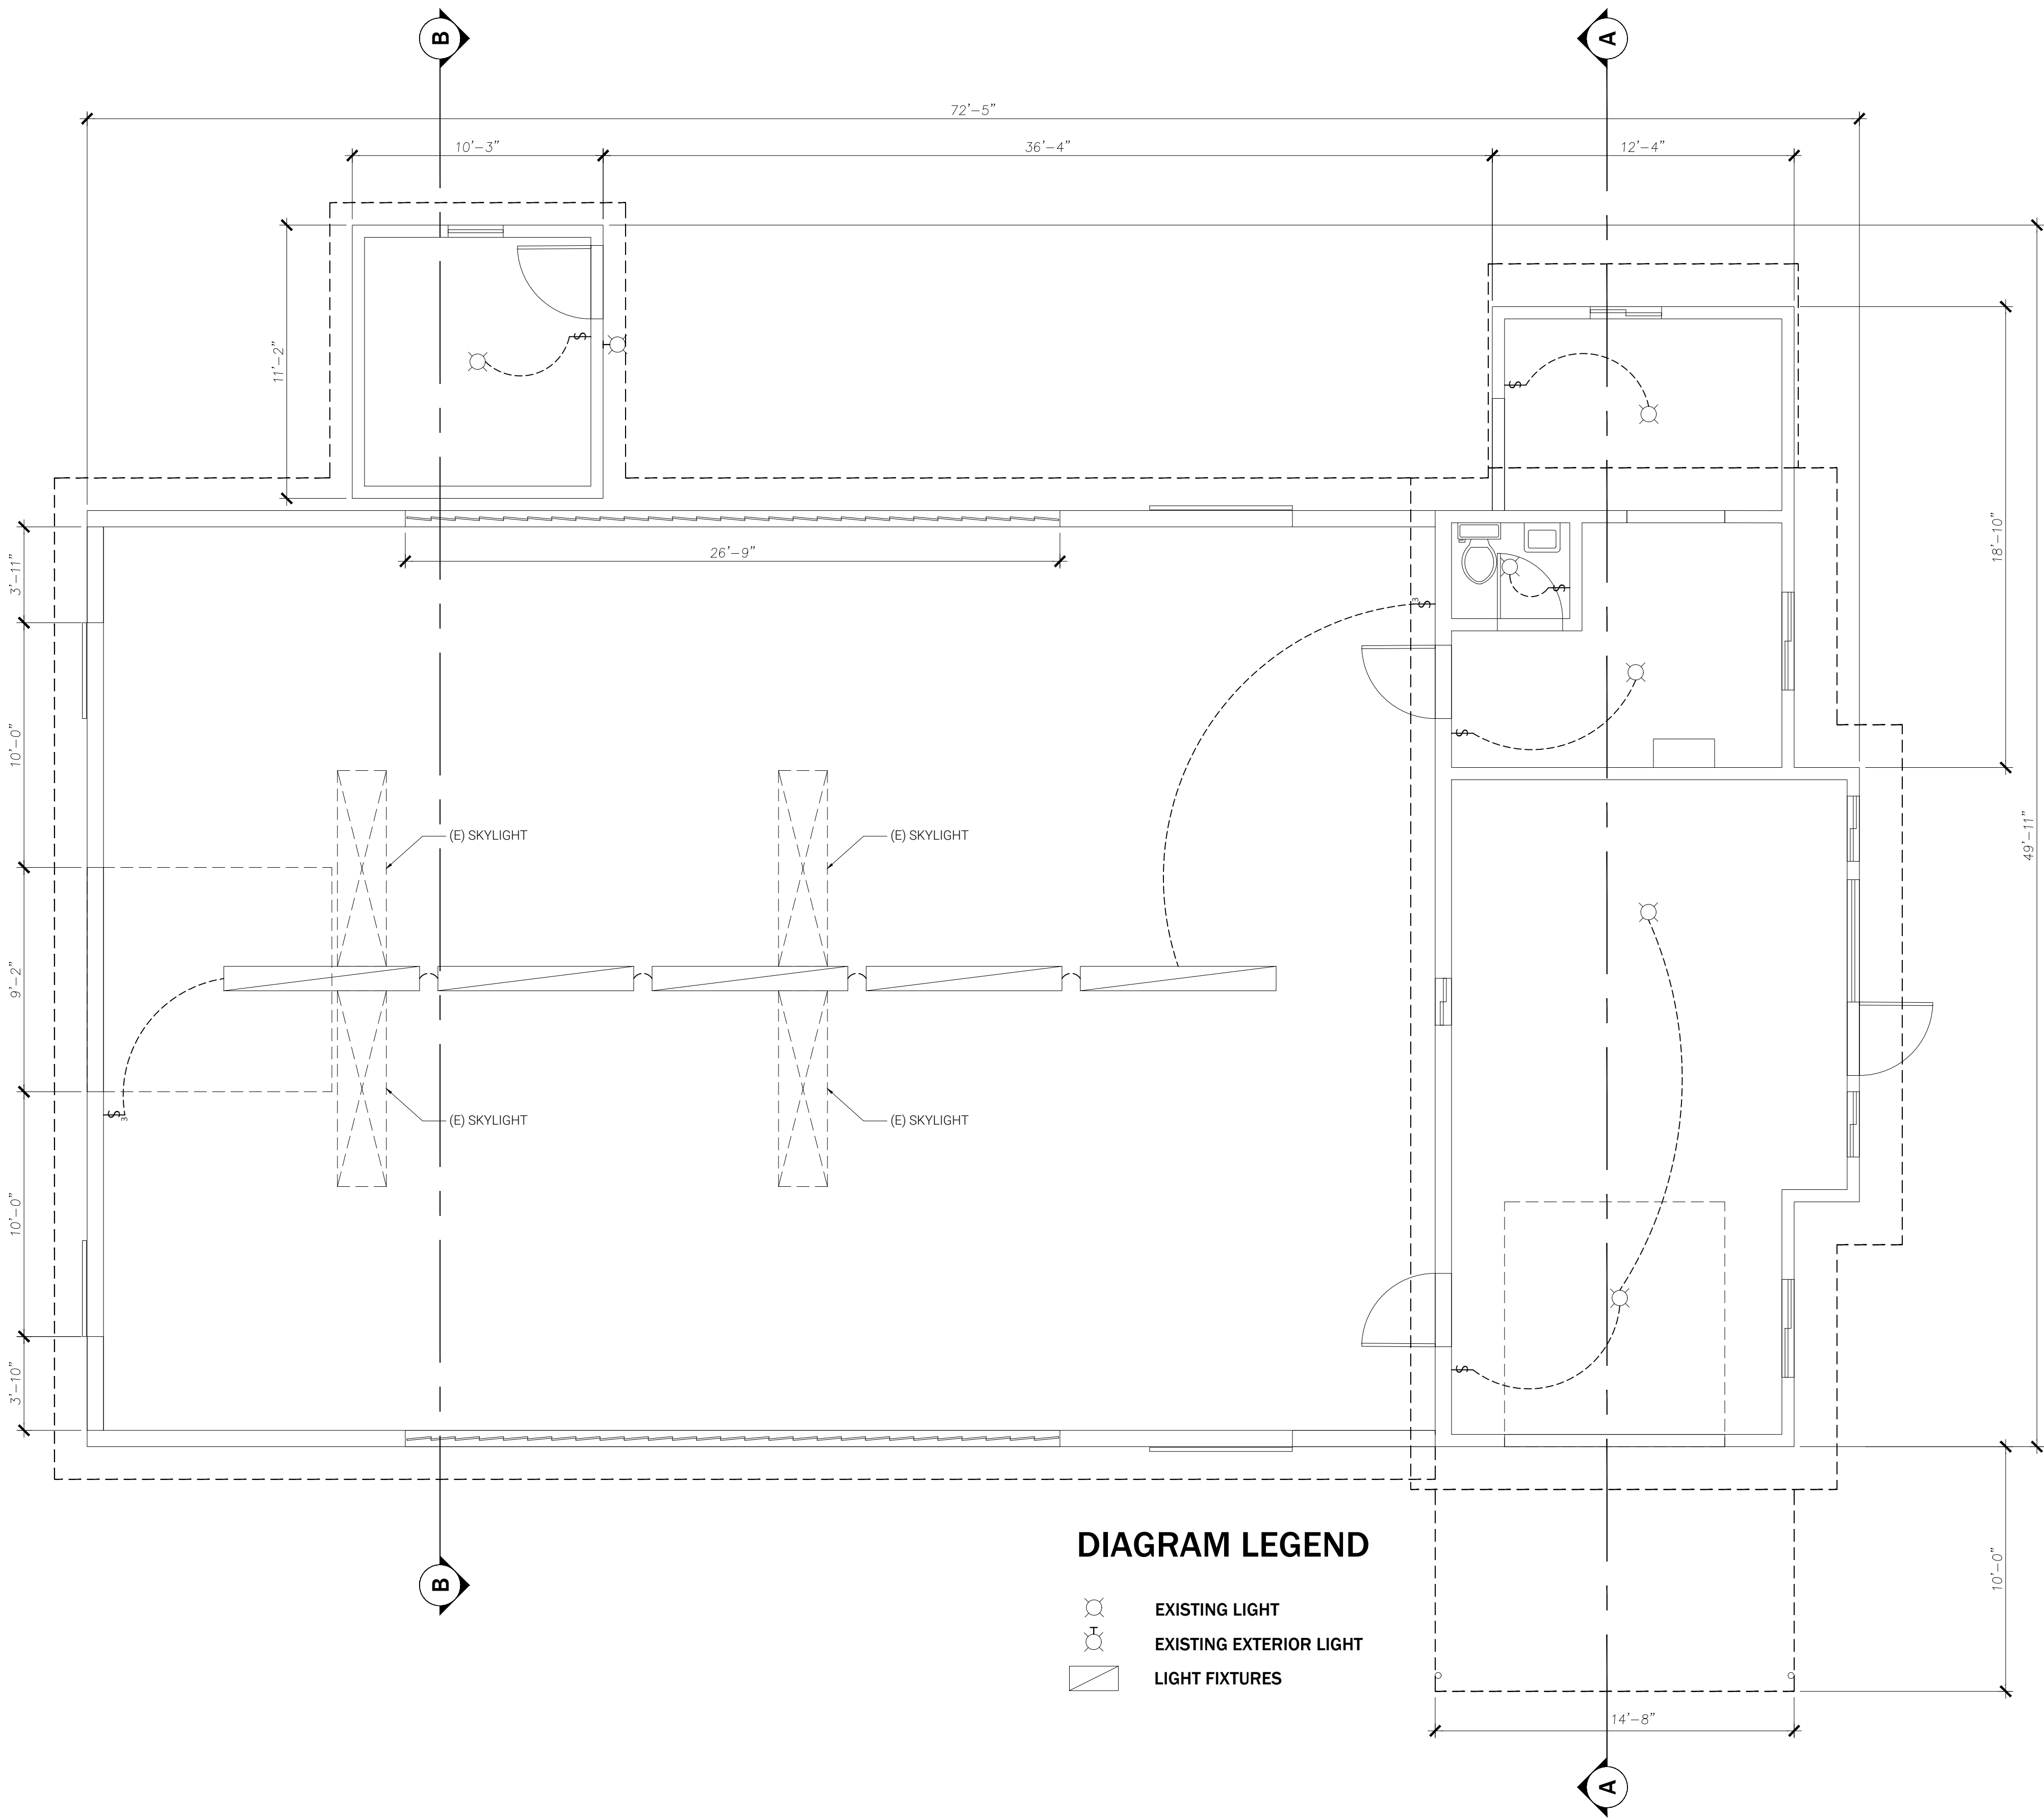

1 EXISTING REFLECTED CEILING PLAN
SCALE: 3/4"=1'-0"

DIAGRAM LEGEND

- EXISTING LIGHT
- EXISTING EXTERIOR LIGHT
- LIGHT FIXTURES

NO.	REVISION	DATE	BY
1			
2			
3			
4			

REID LERNER ARCHITECTS
PHONE 408-842-9942
FAX 408-842-9971
REIDLERNER@YAHOO.COM
7680 MONTEREY ST #105
GILROY, CA 95020

REID LERNER
ARCHITECTS
STATE OF CALIFORNIA
C 19283

FURTADO RANCH
7955 FERGUSON ROAD
GILROY, CA 95020
EXISTING STRUCTURES BUILDING: F

MILK BARN
EXISTING RCP

Drawn	VE
Checked	RL
Date	05.06.22
Scale	AS NOTED
Issued For	PERMIT
Sheet	

A1.03