

PLN23-094

Additional Information

Planning Office


1) Please provide images of the gate as-built



Planning Office

2) Please show the location of the electrical Equipment and keypad/pass


Elevation Plan

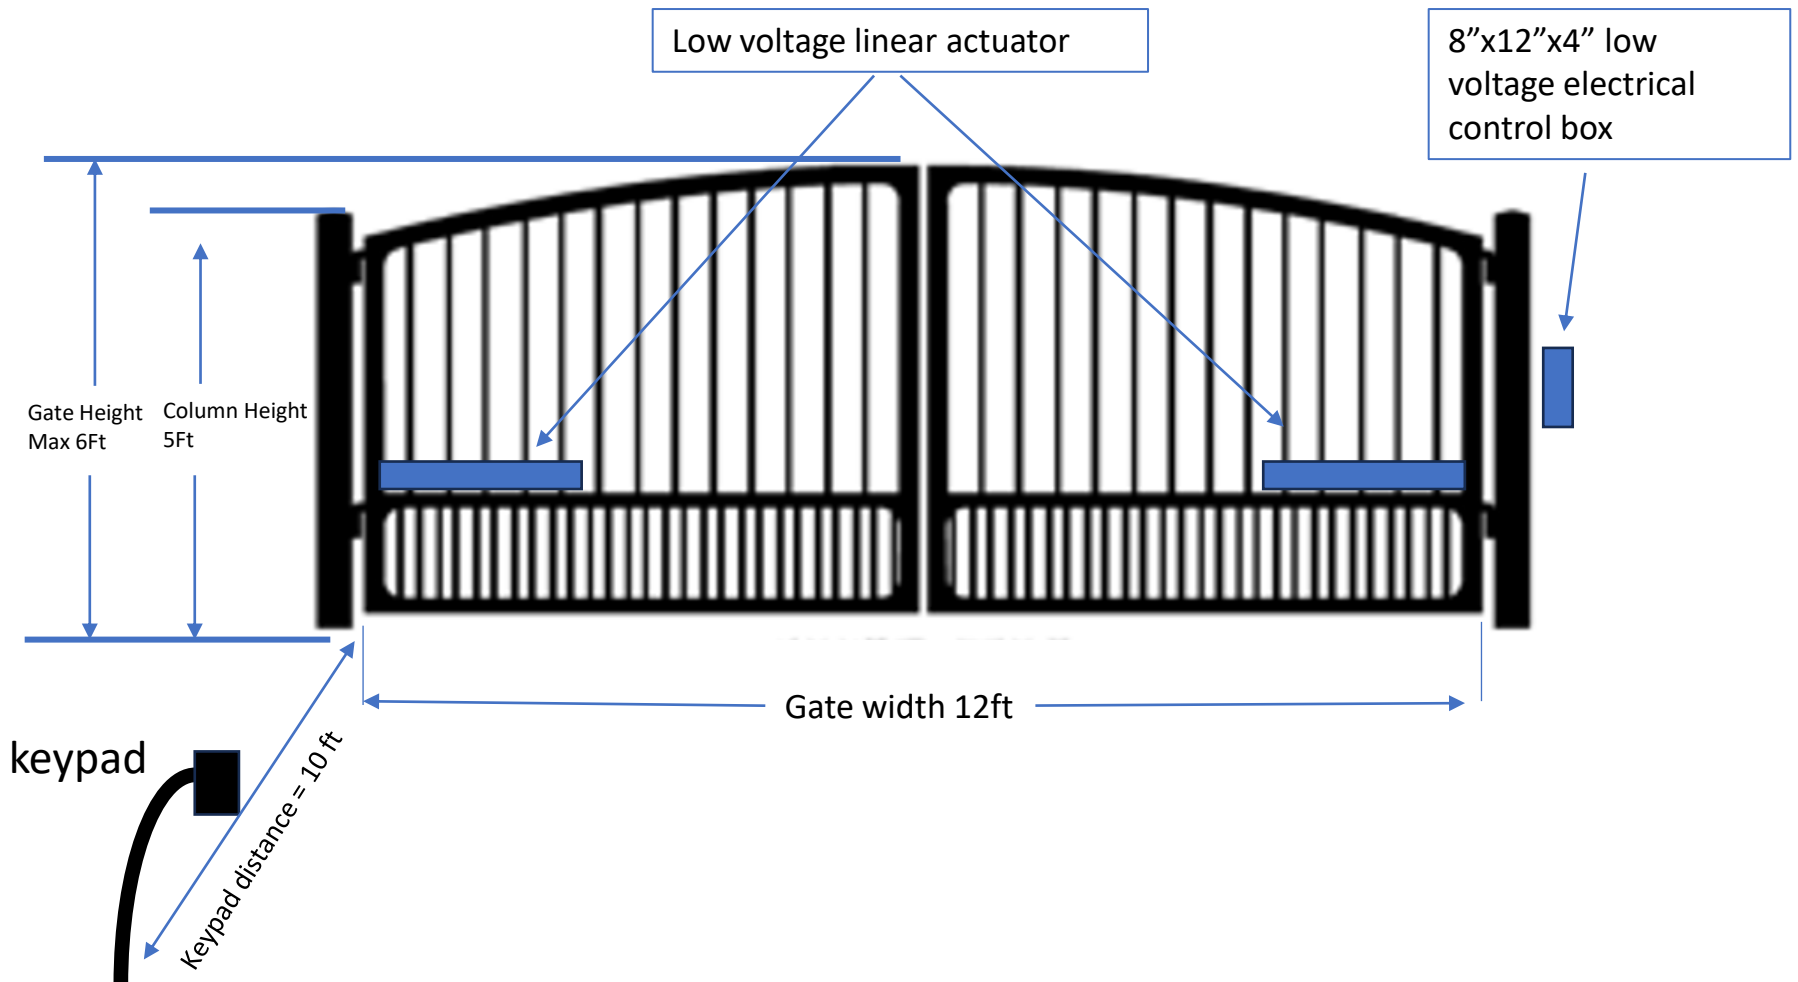

Note: gate setback from property line = 25 feet

Planning Office


3) Please include the paved area (driveway) on the site plans

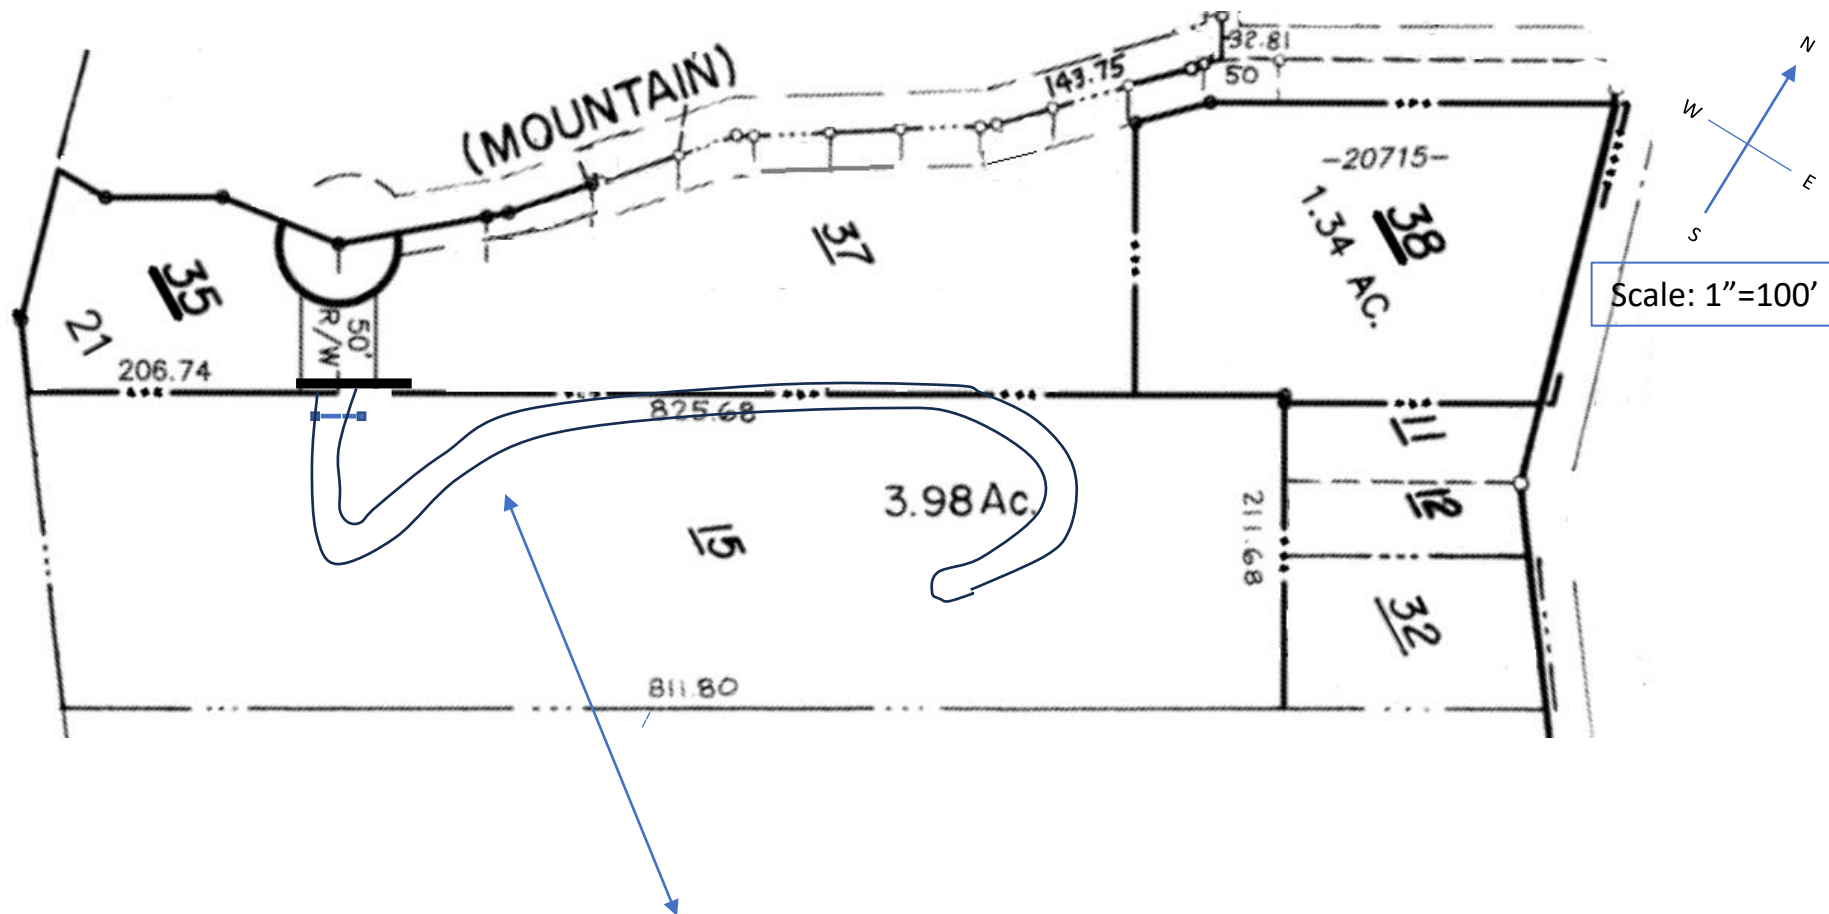

100% of Mountain drive and the driveway for 20799 is covered with pavement


Environmental Health

5) Accurately locate and show the location of the existing wastewater treatment system

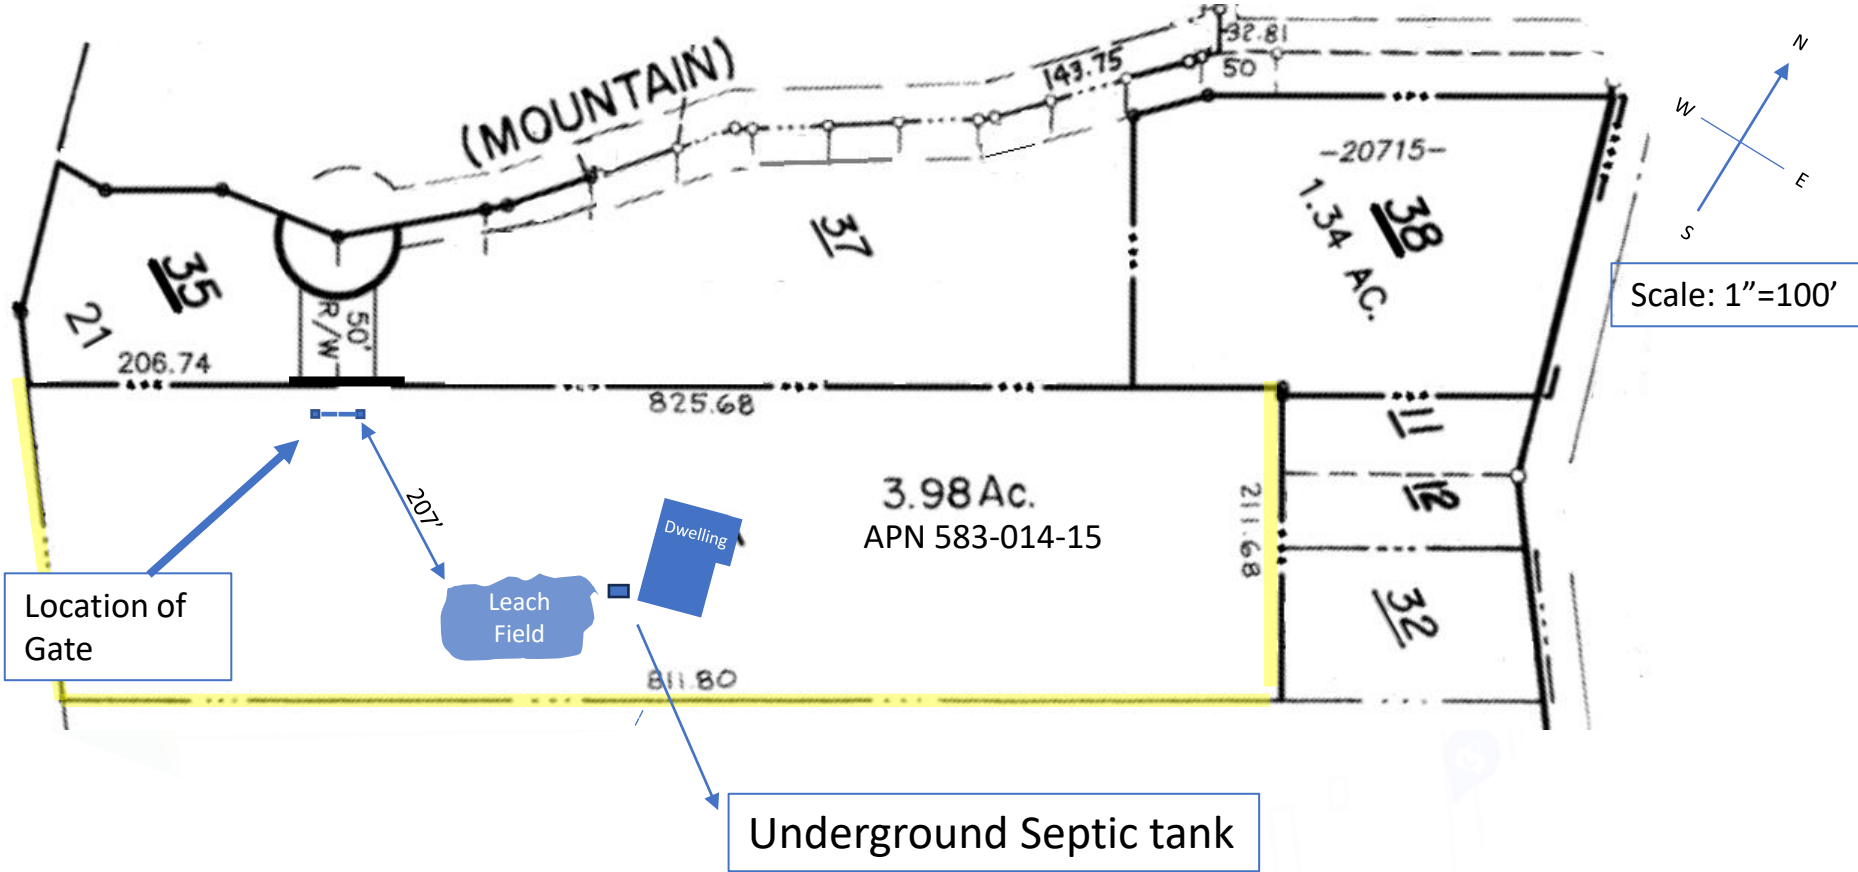

Fire Marshal


6) Plan that includes the entire site, including the driveway, fire hydrants, turnouts, turnaround and structures. Gate does not affect access to turnouts or turnarounds and is not near any structures: Gate is more than 50 ft from the turnaround and any existing structures.

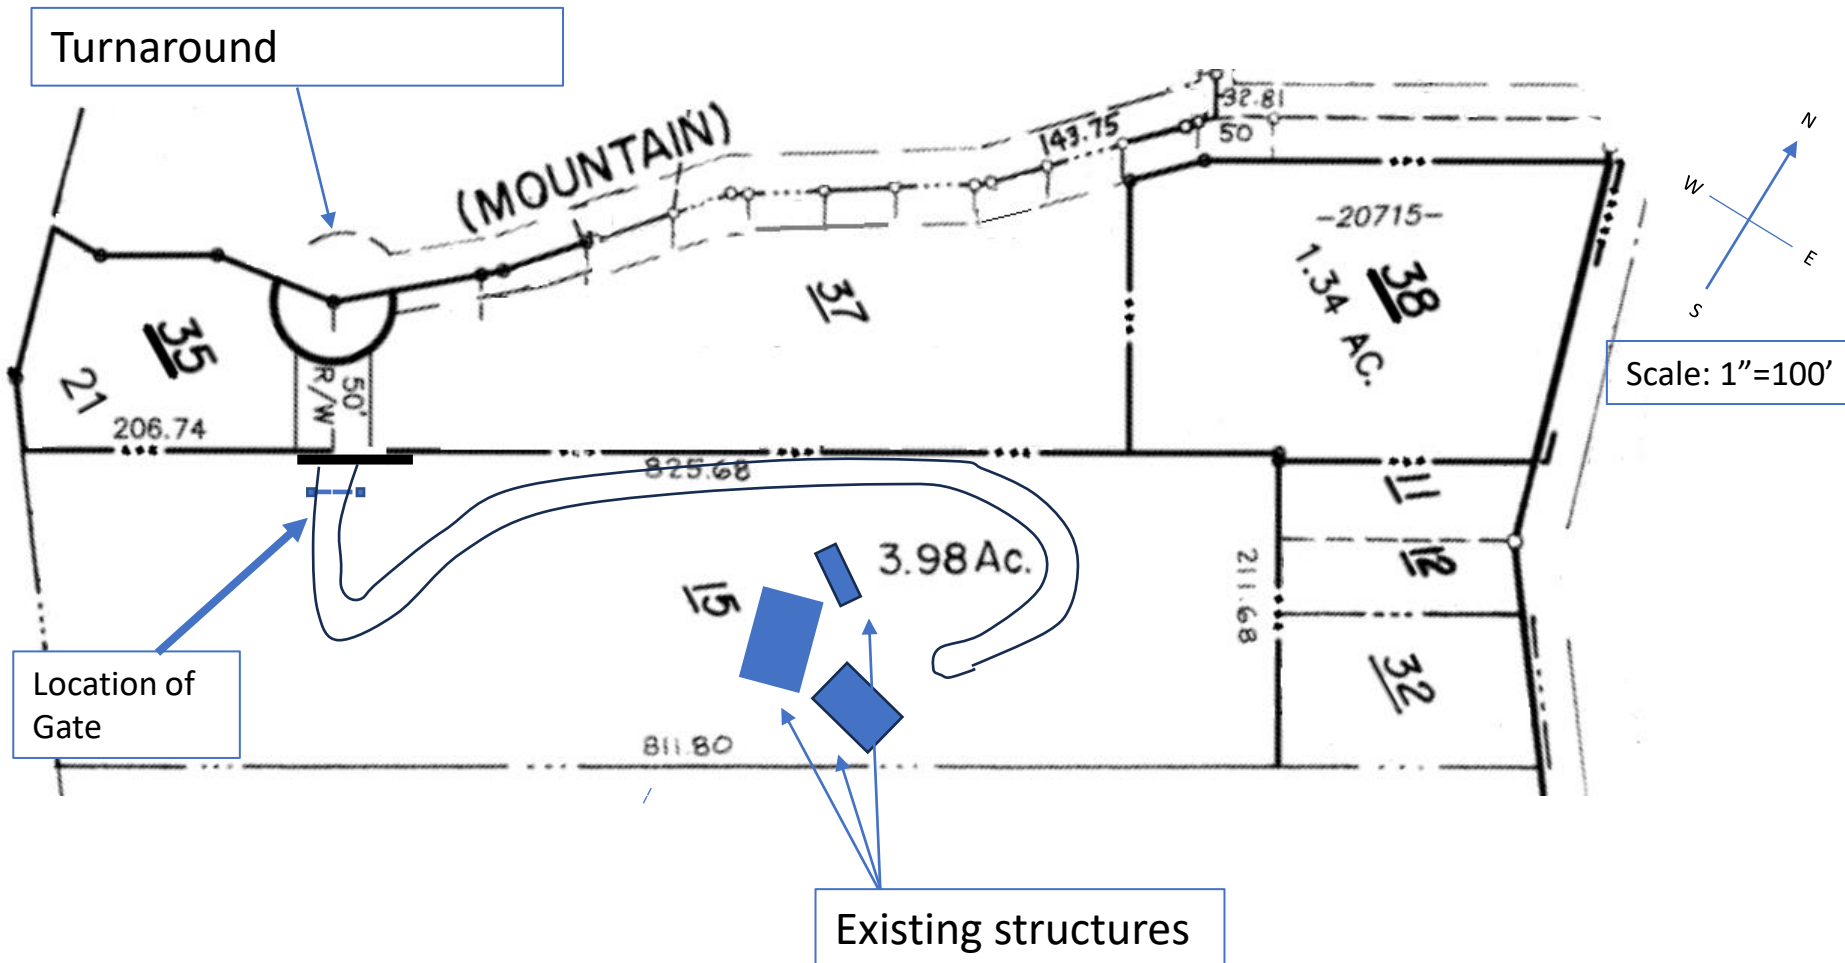

Fire Marshal

7) Gate is Mechanical , Knox Key Switch located on the keypad, testing documentation not available

8) Clear drivable width of gate meets CFMO-A3 (12 ft)

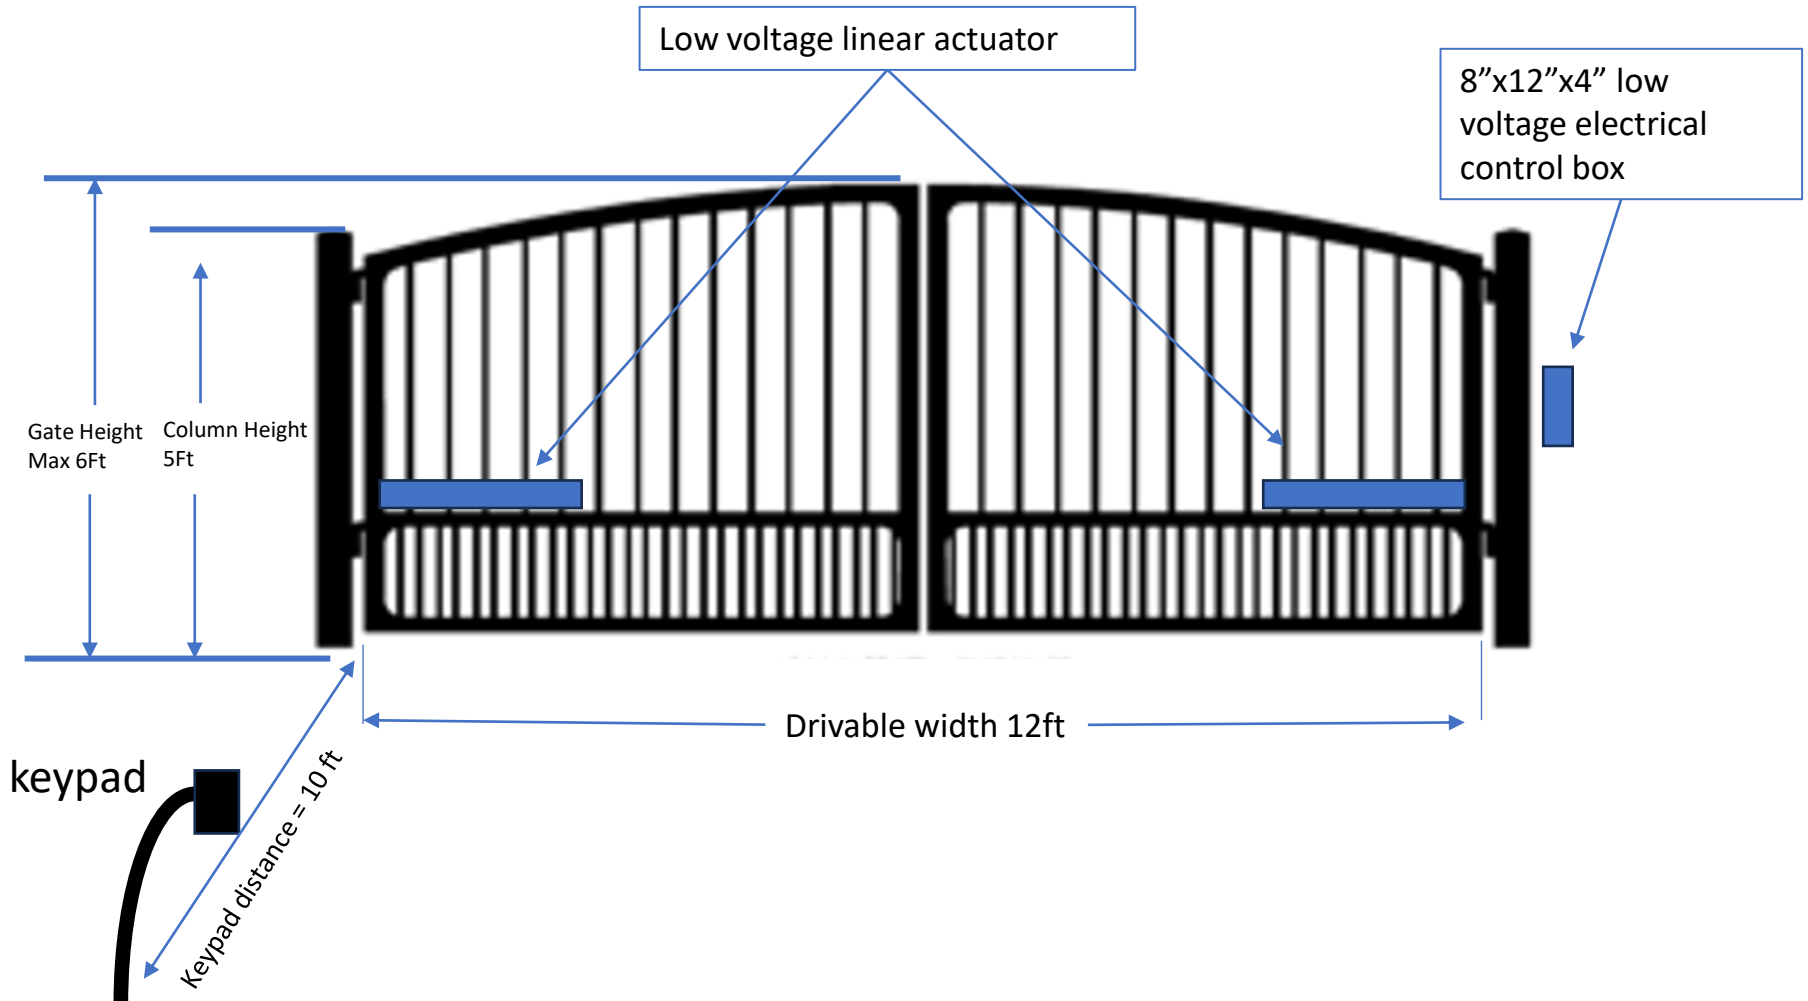

Note: gate setback from property line = 25 feet

Fire Marshal

6 Photo of existing Knox key

